



EXPRESS MAIL NO. EV170132831US

IN THE UNITED STATES PATENT AND TRADEMARK OFFICE

Applicants : Giampiero Maggioni et al.  
Application No. : 09/740,737  
Filed : December 18, 2000  
For : LOOP-TYPE VOLTAGE REGULATING DEVICE

Examiner : Julio C. Gonzalez  
Art Unit : 2834  
Docket No. : 856063.677  
Date : September 12, 2002

Commissioner for Patents  
Washington, DC 20231

REQUEST FOR DRAWING CHANGE

Commissioner for Patents:

Drawing changes, as indicated in red on the attached drawing, are hereby submitted for approval by the Examiner.

Respectfully submitted,  
Giampiero Maggioni et al.  
Seed Intellectual Property Law Group PLLC

E. Russell Tarleton  
E. Russell Tarleton  
Registration No. 31,800

ERT:aep

Enclosures:

Redlined Figures 5

701 Fifth Avenue, Suite 6300  
Seattle, Washington 98104-7092  
Phone: (206) 622-4900  
Fax: (206) 682-6031

D:\NrPortbl\li\Manage\ATHENAP\317201\_1.DOC

PATENT

#11/11 to the  
draftsman  
J. Evans  
9-19-02

RECEIVED  
SEP 19 2002  
TECHNOLOGY CENTER 2800

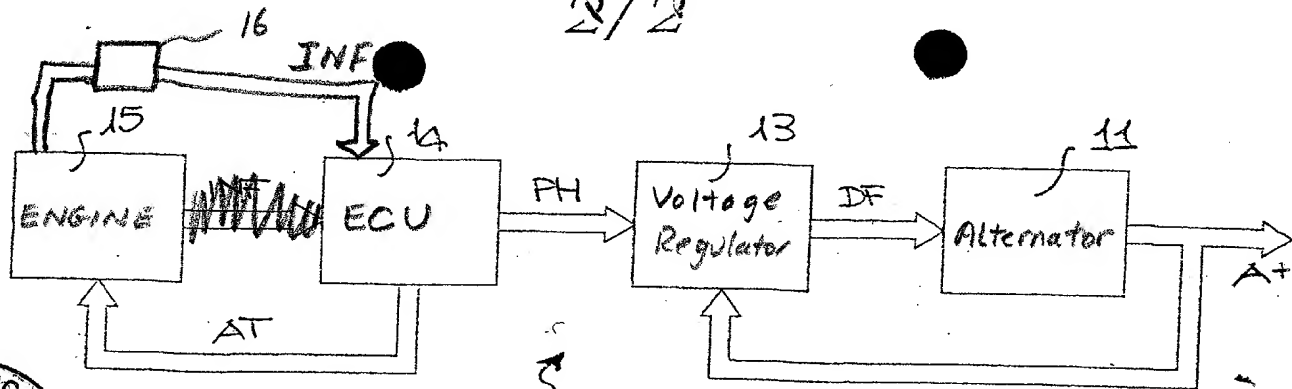


FIG. 5

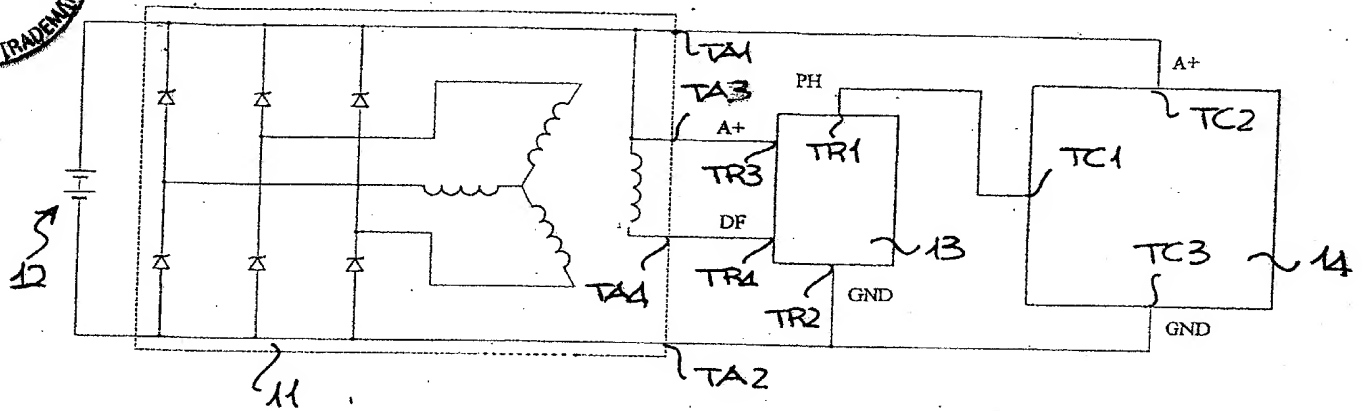


FIG. 4



RECEIVED  
SEP 19 2002  
TECHNOLOGY CENTER 2800